


LEXINGTON AVENUE

Urology

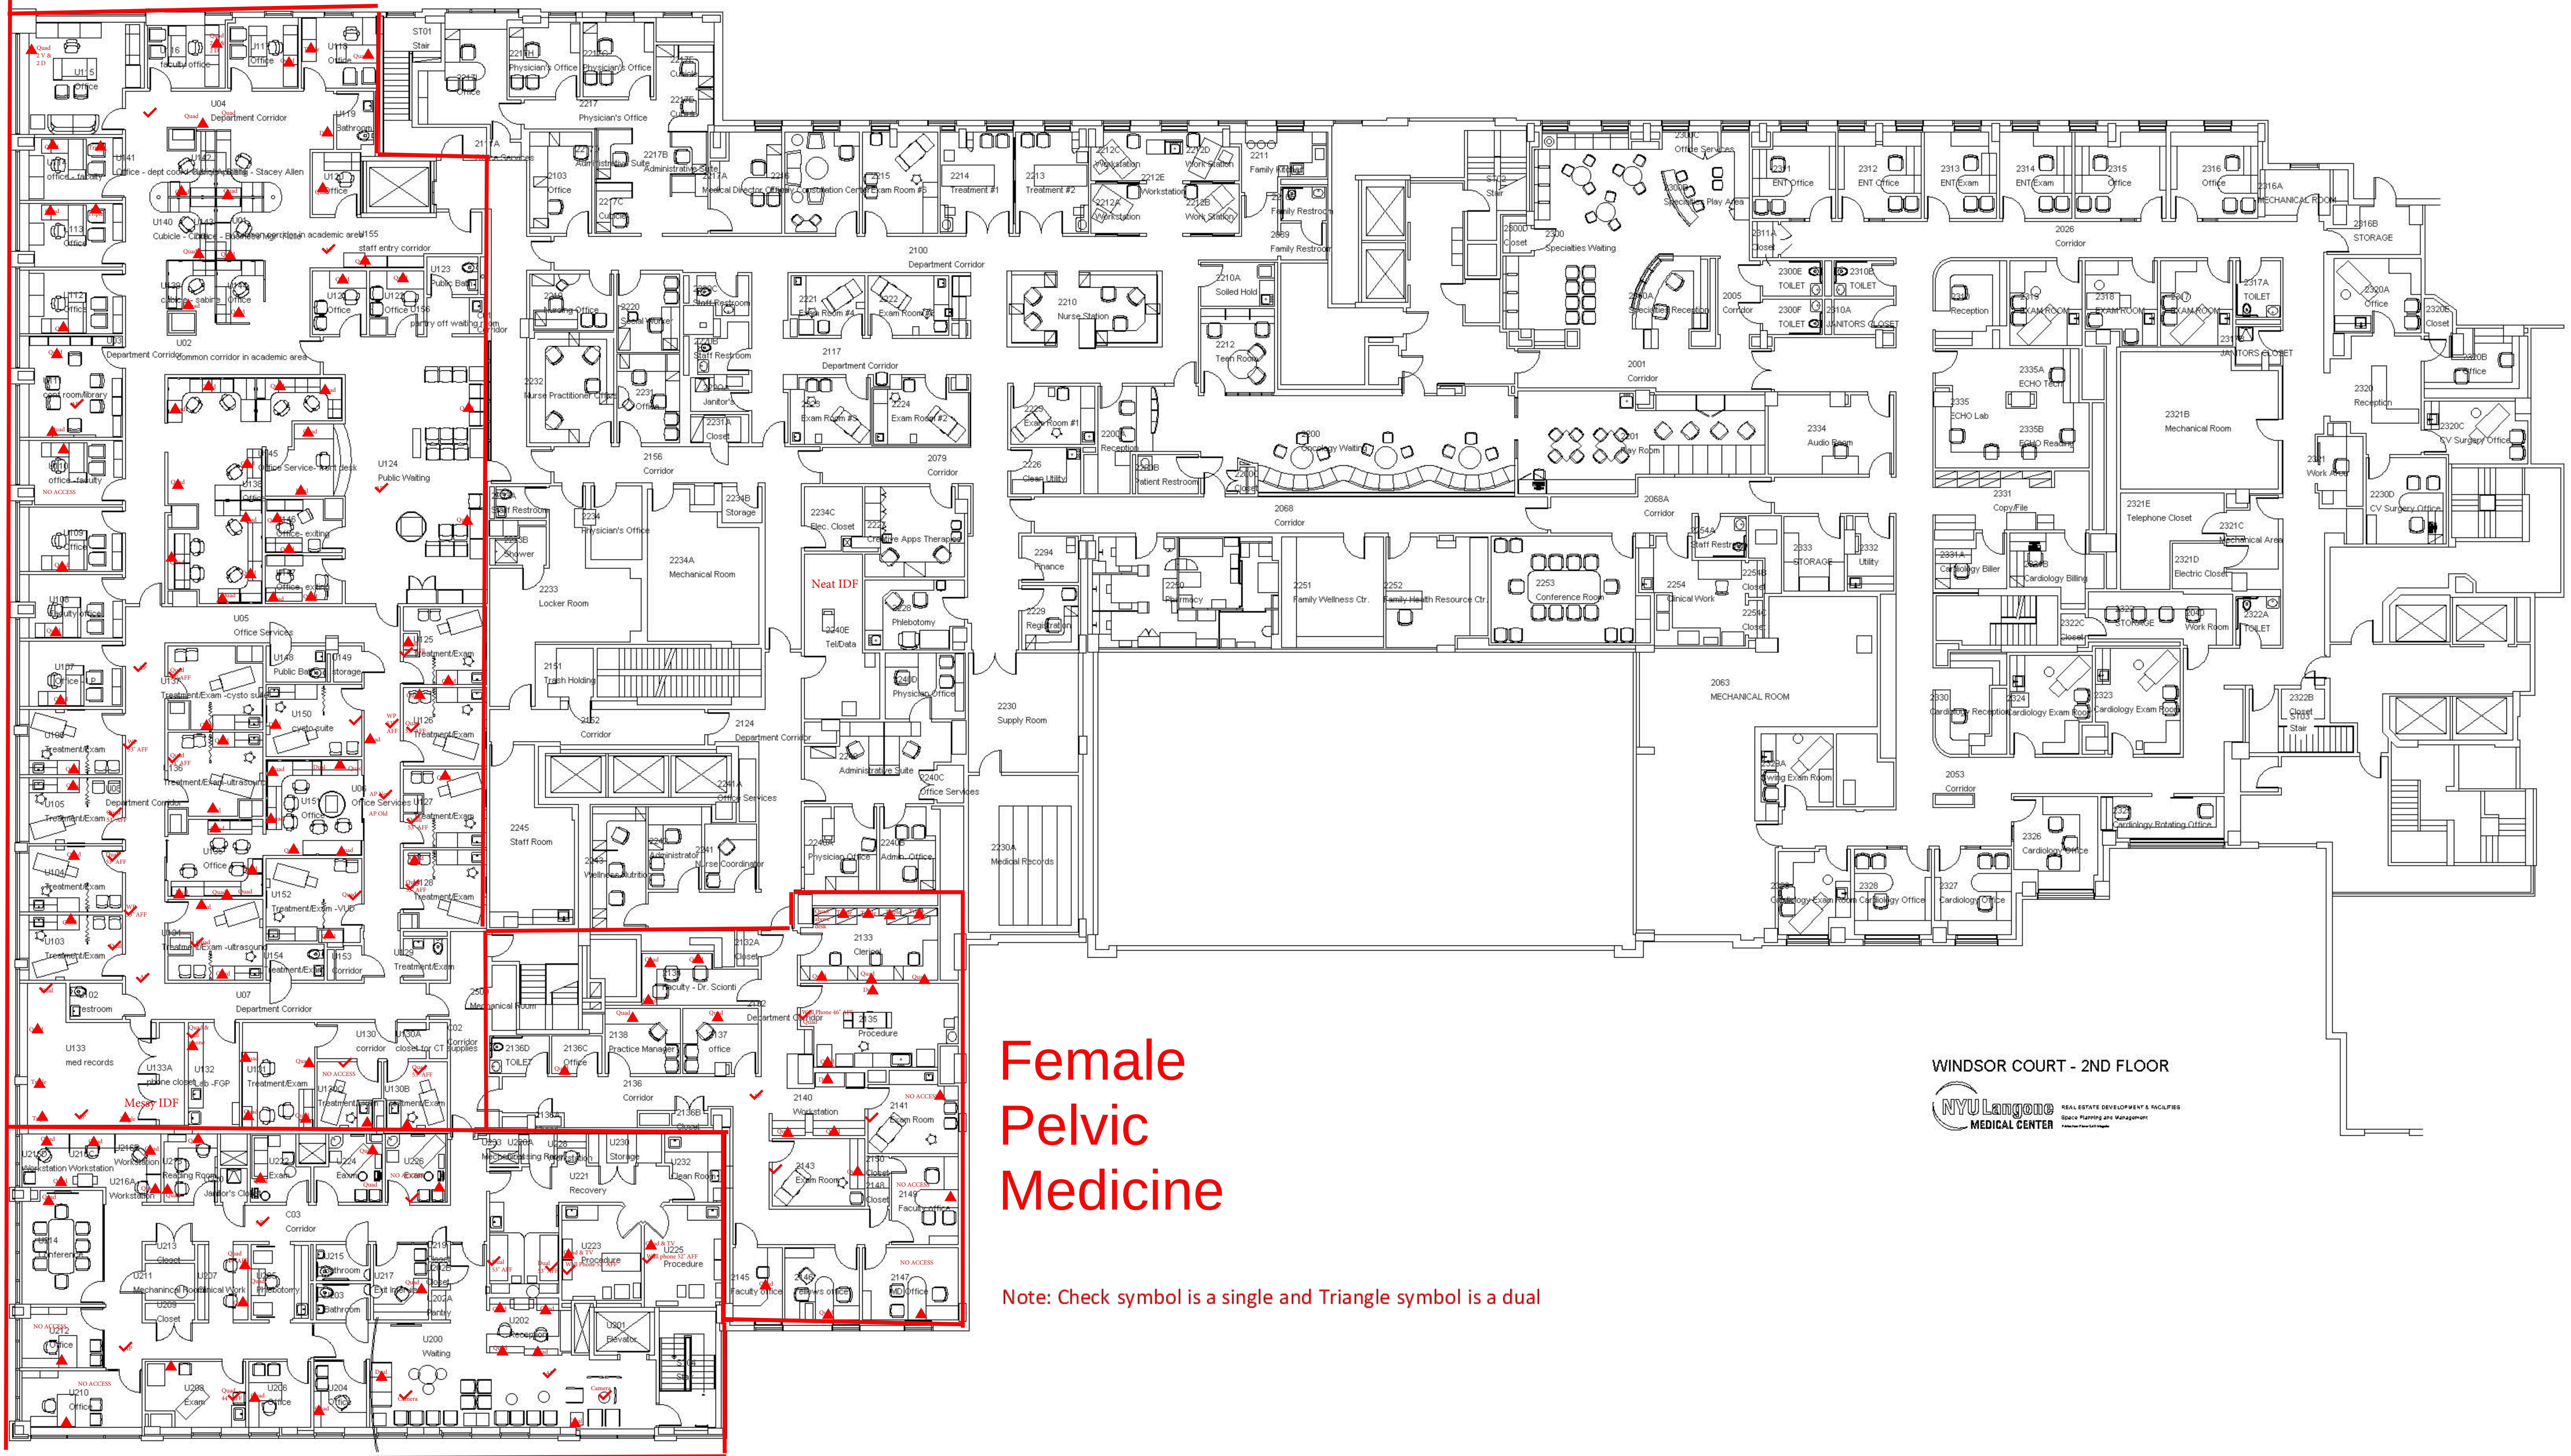

Female
Pelvic
Medicine

Note: Check symbol is a single and Triangle symbol is a dual

Prostate Center

WINDSOR COURT - 2ND FLOOR



EAST 31st STREET